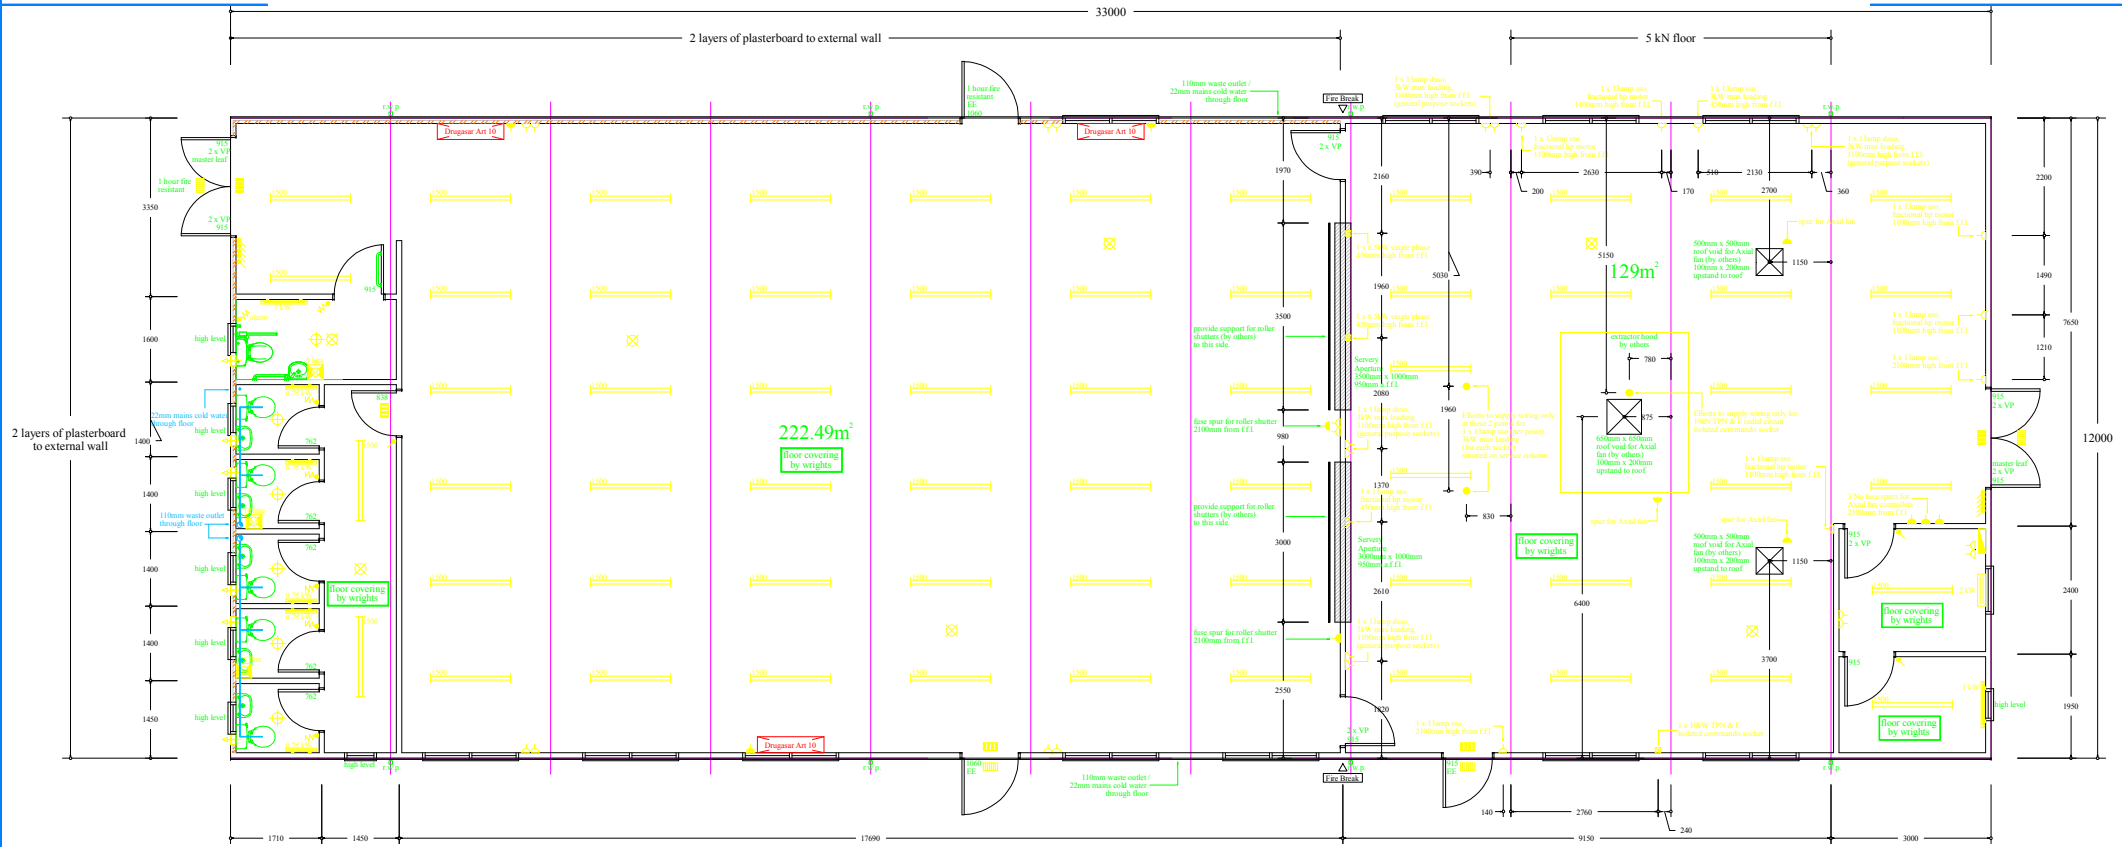

NOTES

- This drawing and any information or descriptive matter set hereon is the confidential property of Wright Contractors; and must not be disclosed, loaned, copied or used for manufacturing, tendering or any other purpose without the prior consent in writing of Wright Contractors.
- All dimensions are to be checked on site.
- Do not scale from this drawing, work to figured dimensions only.

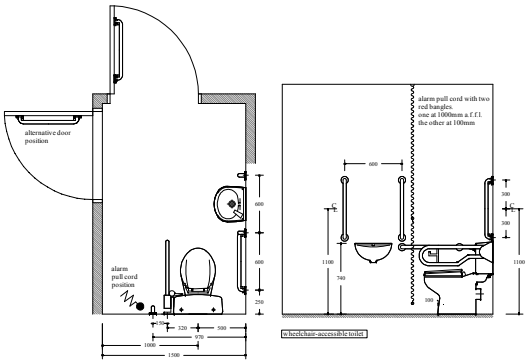

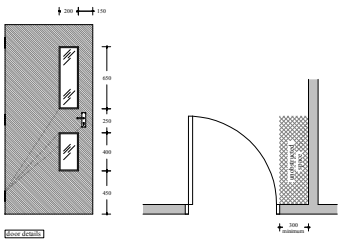

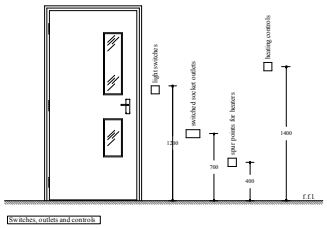

As Built Drawing

Wo 5609

New Canteen/Kitchen Building

- General Arrangement -

SCALE	DRAWN BY	DATE
1 : 50	J.A.	11.05.06

DRAWING NUMBER: Wo - 5609 - 101 ab

David Mob: 07966221656
Stuart Mob: 07976926707 • Fax 0151 5471777

Wright Contractors - Unit 2 - Deltic Way - Knowsley Industrial Park - Merseyside - L33 7BA